
# BRIGHTLEAF AT THE PARK TRACT 8, PHASE 2 & 3

## AS-BUILT RECORD DRAWINGS

SITE PLAN CASE D06-953 (APPROVED BY CITY COUNCIL ON 06-02-2008) BE PROJECT # NCR142017 / DURHAM CASE # D1400393

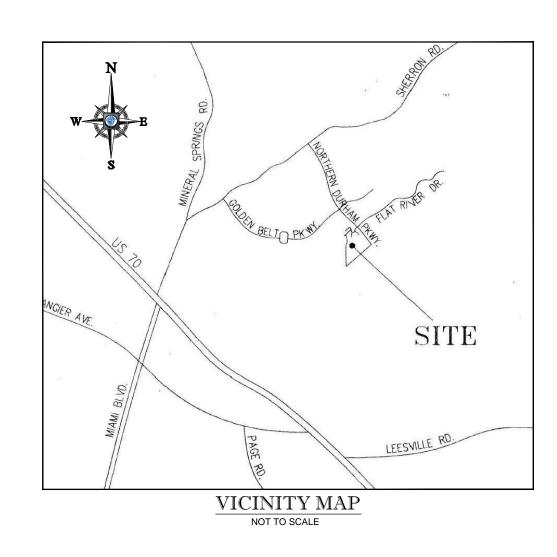

DEVELOPER/OWNER	MREC - BRIGHTLEAF, LLC C/O LSTAR MANAGEMENT 516 N. WEST STREET RALEIGH, NC 27603 ADAM ASHBAUGH, PE, AICP ADAM@LSTARLAND.COM 919.256.1981
CIVIL ENGINEER	BOHLER ENGINEERING, NC, PLLC (NCBELS P-1132) 4011 WESTCHASE BLVD, SUITE 290 RALEIGH, NC 27607 LANDON LOVELACE, PE, LEED AP-ND, NCLID LLOVELACE@BOHLERENG.COM 919.578.9000
LANDSCAPE ARCHITECT	BOHLER ENGINEERING, NC, PLLC 4011 WESTCHASE BLVD, SUITE 290 RALEIGH, NC 27607 JEFF WESTEMORELAND, RLA, ASLA JWESTMORELAND@BOHLERENG.COM 919.578.9000

#### SHEET INDEX

C-0.0	COVER SHEET	
C-1.0	PLAN VIEW	
0 0 0	DDOE!! FO	

### FIELD SURVEY CERTIFICATION STATEMENT


I, MICHAEL A. ROSELLI, AS A DULY REGISTERED PROFESSIONAL LAND ENGINEER IN THE STATE OF NORTH CAROLINA, HEREBY CERTIFY THAT THE DATA SHOWN ON THIS DRAWING, OBTAINED UNDER MY SUPERVISION, IS AN ACCURATE AND COMPLETE REPRESENTATION OF WHAT WAS CONSTRUCTED IN THE FIELD, THAT THE PHYSICAL DIMENSIONS OR ELEVATIONS SHOWN THUS ARE AS-BUILT CONDITIONS AND THE FACILITY WAS CONSTRUCTED ACCORDING TO THE APPROVED PLANS, EXCEPT OTHERWISE NOTED

NAME: MICHAEL A. ROSELLI, PE DATE: 09.16.2015



#### ENGINEER CERTIFICATION STATEMENT

I, MICHAEL A. ROSELLI, AS A DULY REGISTERED PROFESSIONAL ENGINEER IN THE STATE OF NORTH CAROLINA, HAVING BEEN AUTHORIZED TO OBSERVE PERIODICALLY THE CONSTRUCTION OF THE PROJECT, BRIGHTLEAF AT THE PARK TRACT 8 PHASE 2 & 3, HEREBY STATE THAT, TO THE BEST OF MY ABILITIES, DUE CARE AND DILIGENCE WAS USED IN THE OBSERVATION OF THE CONSTRUCTION SUCH THAT BY MY INSPECTION OF THE CONSTRUCTED IMPROVEMENTS AND MY REVIEW OF THE AS-BUILT SURVEY DATA, I HEREBY CERTIFY THAT THE (1) PUBLIC IMPROVEMENTS, (2) PRIVATE IMPROVEMENTS, AND (3) PUBLIC SAFETY OF THE ABOVE REFERENCED PROJECT AS CONSTRUCTED ARE IN COMPLIANCE WITH THE REQUIREMENTS OF THE IMPROVEMENTS AS PRESCRIBED IN THE APPROVED CONSTRUCTION DRAWINGS, APPROVED DESIGN DOCUMENTS, AND/OR ANY APPROVED MODIFICATIONS, EXCEPT AS NOTED IN RED ON THE 'AS-BUILT' DRAWINGS. FURTHERMORE, I CERTIFY THAT THE RED-NOTED EXCEPTIONS DO NOT ADVERSELY AFFECT THE REQUIRED PERFORMANCE OR PUBLIC SAFETY ASPECTS OF THE

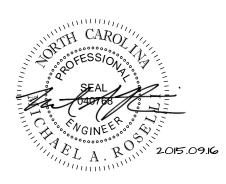

BRIGHTLEAF AT THE PARK TRACT 8, PHASE 2 & 3 AS-BUILTS MREC -

SCALE:

**BEFORE YOU DIG** 

It's fast. It's free. It's the law

**RECORD DRAWING** NOT FOR CONSTRUCTION

AS NOTED

REVISIONS

2015.09.16 DURHAM COMMENTS

BRIGHTLEAF

LOCATION OF SITE NORTHERN DURHAM PKWY DURHAM, NC



RALEIGH, NC 27607 Phone: (919) 578-9000 Fax: (919) 703-2665 NC@BohlerEng.com

**ASBUILTS** 

COVER SHEET

NAME: MICHAELA ROSELLI PE DATE: 09.16.2015 H:\2014\ncr142017.1\Drawings\plan sets\as-builts\ncr142017.1 - Cover.dwg Printed by: Mroselli 9.17.15 @ 5:49 PM Last Saved by: Mr